SECTION 5, TOWN 11 NORTH, RANGE 3 WEST,

Date March 1892 Surveyor J. Gapsby

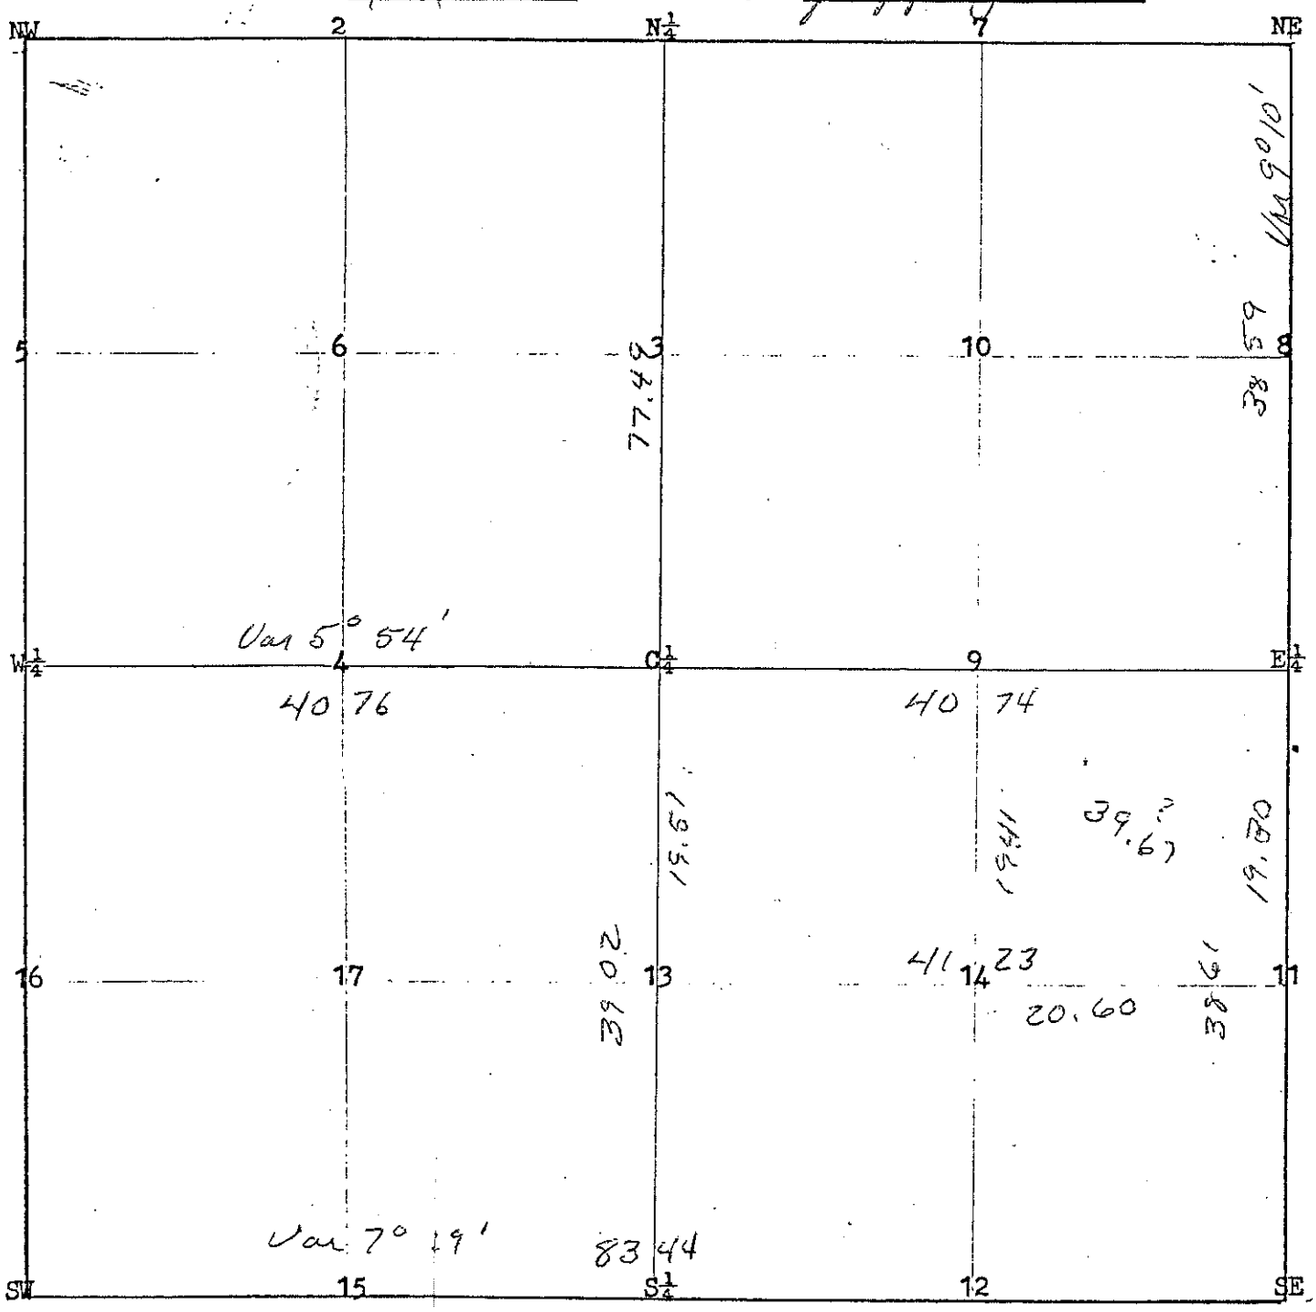

SE - Sugar 20 N 3½ E 95
B Oak 6 S 46¼ E 40
12 - B Oak 7 S 42½ E 15⅛
W Oak 13 N 72½ W 75
S¼ - B Oak 10 N 3 W 123¾
B Oak 10 N 5 W 201½?
15 - Lynn 18 N½ W 151½
W Oak 20 N 57½ W 137
SW - B Oak 14 N 31 E 180¼
B Oak 12 N 87 E 172¼
13 - B Oak 5 N 61¼ E 18¼
B Oak 3 N 34½ W 17¼
E¼ - Dogwood 6 N 8 W 11
B Oak 20 N 39 E 153
11 - Sugar 19 S 14½ E 44½

11 - Sugar 20 S 66 W 37
N¼ - B Oak 7 N 41¾ W 70
W Oak 6 S 52 W 62
NE - Butternut 12 S 13¼ W 32¼
Elm 19 N 67 E 84