VERNON
[redacted] COUNTY

Survey Monument Record

TYPE OF MONUMENT: 1 1/4" pipe found in place

STATE PLANE COORDINATES: N _____

E _____

ELEVATION — M.S.L. DATUM: _____

THETA ANGLE: _____

FIELD BOOK: _____ PAGE _____

CORNER NO. _____

SECTION 28

TOWN 13

RANGE 1E

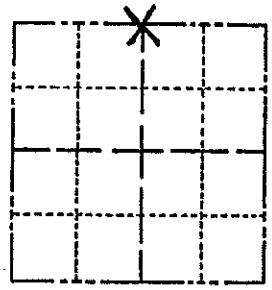

LOCATION
(Indicated by 'X')

N

BASIS FOR MONUMENT LOCATION

(Use reverse side if necessary)

Show info such as: History of corner, with reference to Vol. and pg, dates, surveyor; exact description of monument replaced; if location computed, by taped or EDM traverse; landowner remarks, etc.

1¼" O.D. iron pipe found in place.
Accepted as the true corner location.
Origin unknown.

SEAL:

WISCONSIN
PATRICK A. CARROLL
S-1199
MAUSTON
WIS.
LAND SURVEYOR

CERTIFIED CORRECT: Patrick A. Carroll

Registered Land Surveyor

DATE: 04-19-10

TIE SKETCH
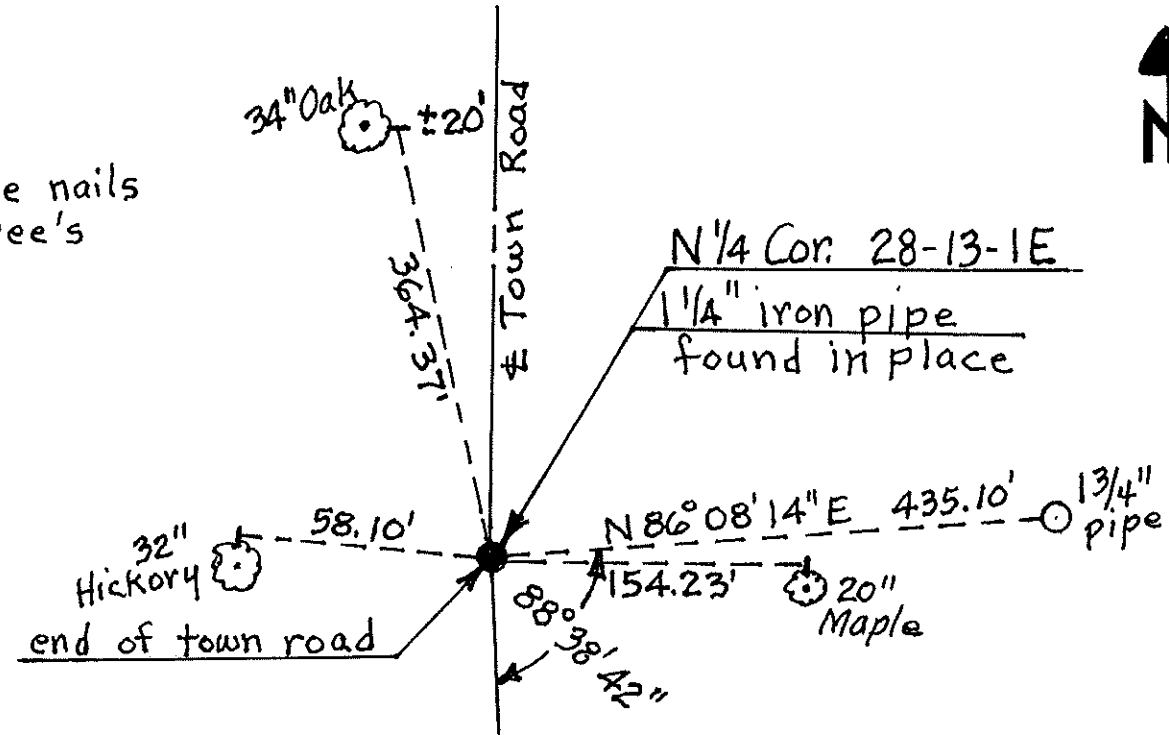
(Show at least four ties)