Vernon County [redacted]

Survey Monument Record

TYPE OF MONUMENT: 1 1/2" X 60" PIPE SET 18" TALL

STATE PLANE COORDINATES: N _____

E _____

ELEVATION — M.S.L. DATUM: _____

THETA ANGLE: _____

FIELD BOOK: _____ PAGE _____

CORNER NO. _____

SECTION 34

TOWN 13N

RANGE R1E

GREENWOOD

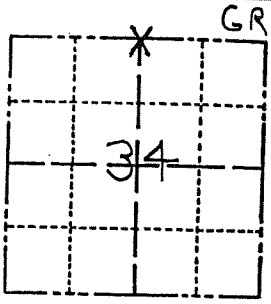

LOCATION
(Indicated by 'X')

N

BASIS FOR MONUMENT LOCATION

(Use reverse side if necessary)

Show info such as: History of corner, with reference to Vol. and pg, dates, surveyor; exact description of monument replaced; if location computed, by taped or EDM traverse; landowner remarks, etc.

SEAL:

PER DISCUSSION WITH ADJACENT LANDOWNER DANIEL SCHROCK WHO STATES THAT HE & OTHER ADJACENT LANDOWNERS AGREE, AS I DO, THAT THE POSSESSION FENCE CORNER IS THE MOST APPROPRIATE LOCATION FOR THIS N1/4 CORNER.

WISCONSIN
PATRICK A. CARROLL
S-1199
MAUSTON
WIS.
LAND SURVEYOR

CERTIFIED CORRECT: Patrick A. Carroll

Registered Land Surveyor

DATE: 7/12/99

TIE SKETCH

(Show at least four ties)

TIES ARE 6" SPIKES

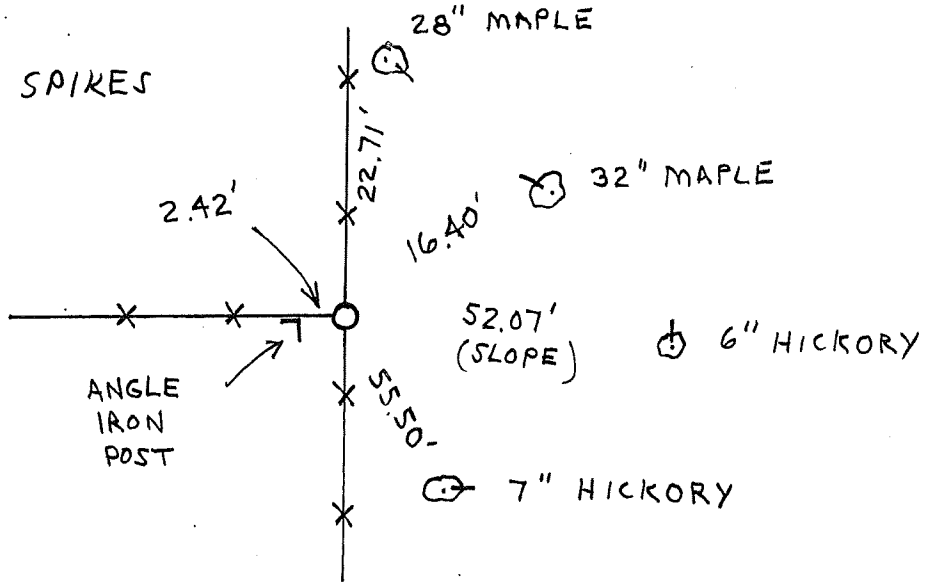

N