FOR VERNON COUNTY, WISCONSIN

Note: This form is intended and designed to fulfill all requirements of Wisconsin Administrative Code, Chapter AE-7.08, U.S. Public Land Survey Monument Record (3)(a)(b)(c)(d)(e)(f)(g)(h)(i). Use additional sheets if necessary.

(a) The One Quarter corner common to Sections 1,12

Township(s) 14 North,Range(s) 7 West.

Vernon County Coordinates: N 205158.642

Datum: _____ E 630273.654

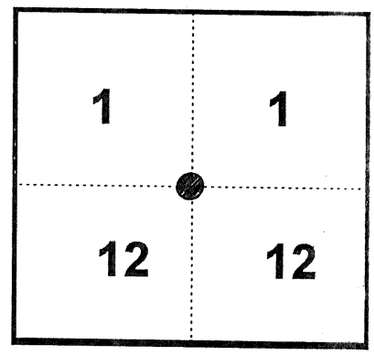

(b)(f)(h) Description of monument found at this corner and if it was accepted, state all evidence (material, testimonial, occupational, plats records, other monuments) used as a basis for accepting. If not accepted or nothing was found, state evidence used as basis for establishing location and what was set. If re-established through lost corner proportionate methods, indicate all monuments, distances and directions used.

1846-1847 Alfred L. Brown established original corner location 40.12 1/2 chains East of the Nothwest corner of Section 12.
12-22-98 Found 3/4 inch bar as per Previous Survey. Replaced it with a Vernon County Monument

(c)(d)(e) Plan view of corner with ties to at lest four (4) witness monuments. If in disagreement with previously established corner, show the distances between the two corners and also indicate ties to disputed corner.

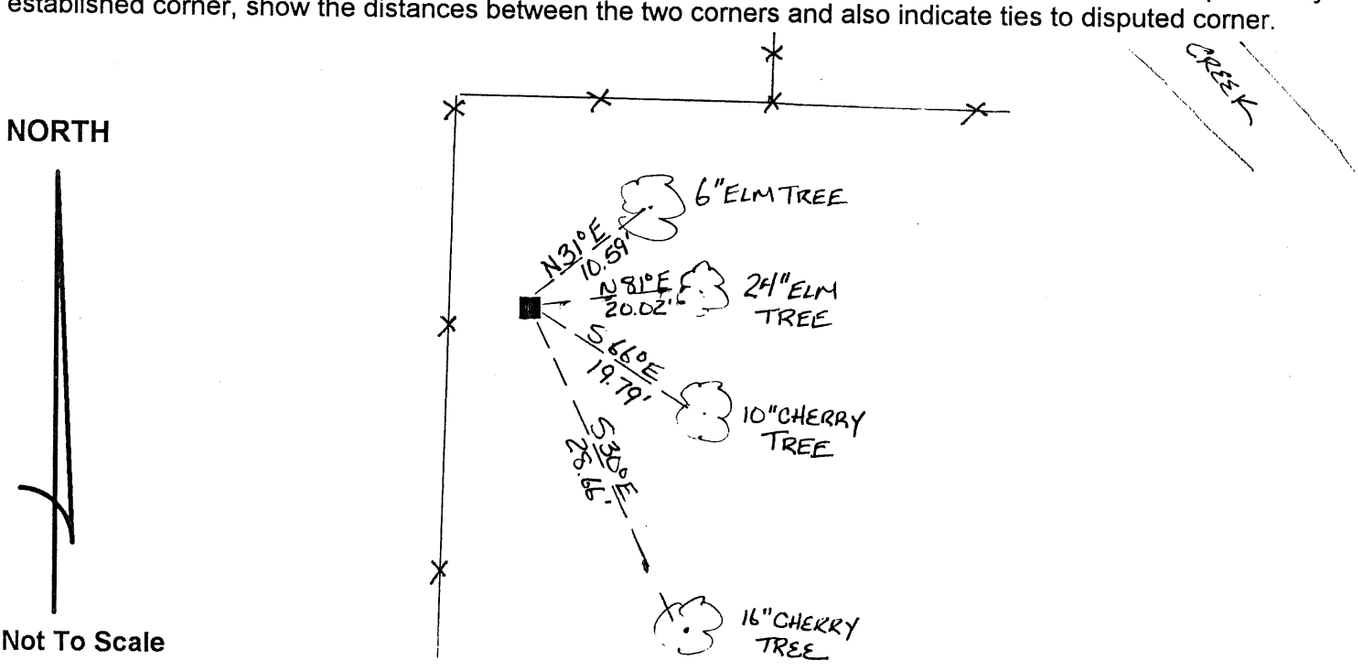

■ = Set Vernon County Monument
(Iron Pipe with 3" brass cap)

SET 60d SPIKES IN TREES

(l) Certify that the corner location on this record was determined by me or under my direction and control and that this U.S. Public Land survey Monument Record is correct and complete to the best of my knowledge and belief.

WISCONSIN CARL M. SANDSNES S-1819 MADISON, WISCONSIN LAND SURVEYOR

Signature 12/30/98 Date

Filed for record in Vernon County Surveyor's Office on _____ **INDEX NO.** _____

342

6