FOR VERNON COUNTY, WISCONSIN

Note: This form is intended and designed to fulfill all requirements of Wisconsin Administrative Code, Chapter AE-7.08, U.S. Public Land Survey Monument Record (3)(a)(b)(c)(d)(e)(f)(g)(h)(i). Use additional sheets if necessary.

(a) The One Quarter corner common to Sections 2,3,10,11

Township(s) 14 North,Range(s) 7 West.

Vernon County Coordinates: N 205154.486

Datum: _____ E 622245.439

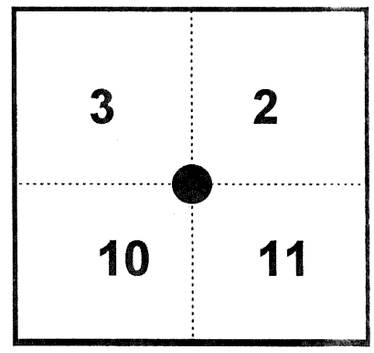

(b)(f)(h) Description of monument found at this corner and if it was accepted, state all evidence (material, testimonial, occupational, plats records, other monuments) used as a basis for accepting. If not accepted or nothing was found, state evidence used as basis for establishing location and what was set. If re-established through lost corner proportionate methods, indicate all monuments, distances and directions used.

1846 Alfred L. Brown established original corner location

11-16-1998 - Found 1 1/2 inch pipe at corner location. Replaced pipe with a Vernon County monument

(c)(d)(e) Plan view of corner with ties to at lest four (4) witness monuments. If in disagreement with previously established corner, show the distances between the two corners and also indicate ties to disputed corner.

NORTH

Not To Scale

■ = Set Vernon County Monument
(Iron Pipe with 3" brass cap)

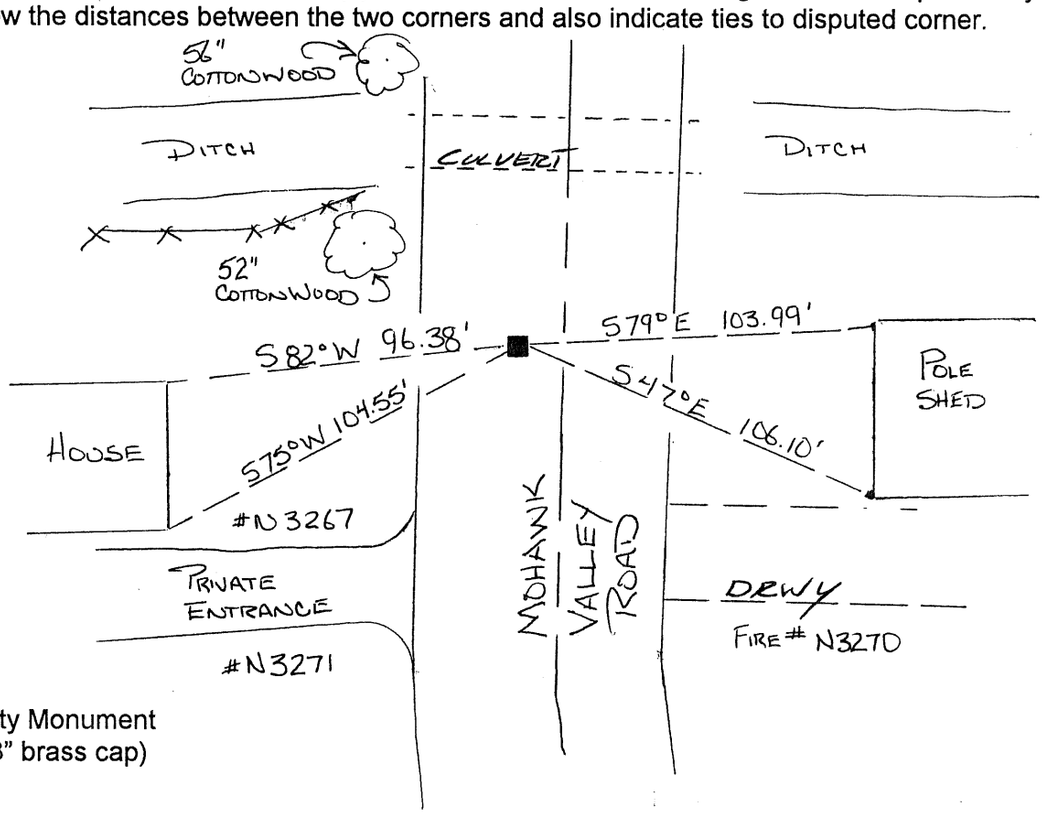

(I) Certify that the corner location on this record was determined by me or under my direction and control and that this U.S. Public Land survey Monument Record is correct and complete to the best of my knowledge and belief.

WISCONSIN
CARL M. SANDSNES
S-1819
MADISON, WISCONSIN
LAND SURVEYOR

Signature 12/30/98 Date

Filed for record in Vernon County Surveyor's Office on _____ **INDEX NO.** _____

1