FOR VERNON COUNTY, WISCONSIN

Note: This form is intended and designed to fulfill all requirements of Wisconsin Administrative Code, Chapter AE-7.08, U.S. Public Land Survey Monument Record (3)(a)(b)(c)(d)(e)(f)(g)(h)(i). Use additional sheets if necessary.

(a) Sections 3

Township(s) 14 North, Range(s) 07, West.

Vernon County Coordinates: N 204963.912

E 617114.495

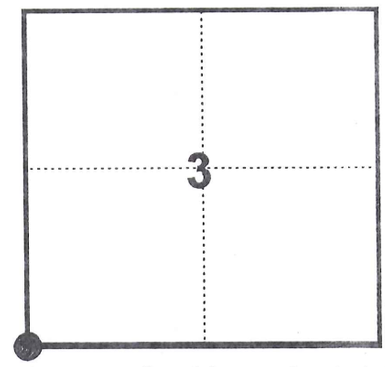

(b)(f)(h) Description of monument found at this corner and if it was accepted, state all evidence (material, testimonial, occupational, plats records, other monuments) used as a basis for accepting. If not accepted or nothing was found, state evidence used as basis for establishing location and what was set. If re-established through lost corner proportionate methods, indicate all monuments, distances and directions used.

1846-1847 - Alfred L. Brown established the original corner location 80 chains North of the Southwest corner of Section 10.

December 22, 1998 - I found a United States Corp of Engineers brass cap as called for in a previous survey tied to the Southwest and South 1/4 corners of Section 3. I accepted it as the corner and witnesses as shown.

(c)(d)(e) Plan view of corner with ties to at lest four (4) witness monuments. If in disagreement with previously established corner, show the distances between the two corners and also indicate ties to disputed corner.

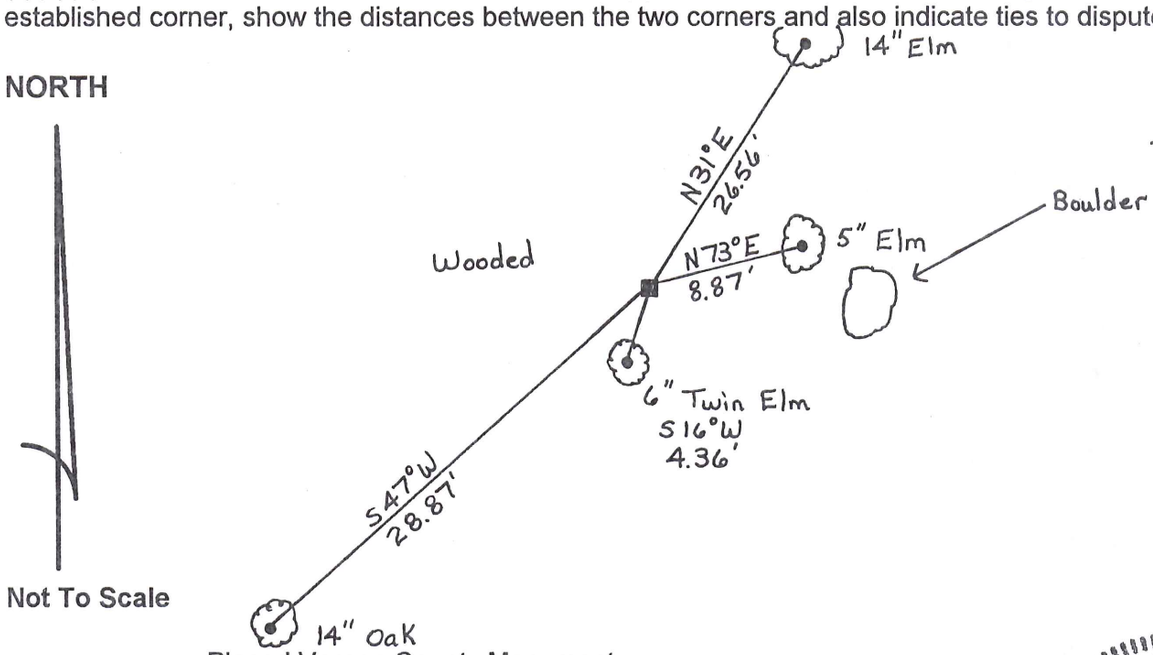

Not To Scale

= Placed Vernon County Monument

● = Placed 60d spike

■ = Found Corp. of Engineers Monument

(l) Certify that the corner location on this record was determined by me or under my direction and control and that this U.S. Public Land survey Monument Record is correct and complete to the best of my knowledge and belief.

WISCONSIN CARL M. SANDSNES S-1819 MADISON, WISCONSIN LAND SURVEYOR

Signature Carl M. Sandsnes — Date December 31, 1998.

Filed for record in Vernon County Surveyor's Office on _____ **INDEX NO.** _____

337

30