FOR VERNON COUNTY, WISCONSIN

Note: This form is intended and designed to fulfill all requirements of Wisconsin Administrative Code, Chapter AE-7.08, U.S. Public Land Survey Monument Record (3)(a)(b)(c)(d)(e)(f)(g)(h)(i). Use additional sheets if necessary.

(a) Sections 11

Township(s) 14 North, Range(s) 07 West.

Vernon County Coordinates: N 199826.859

E 627698.213

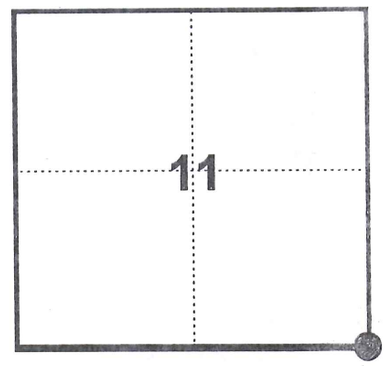

(b)(f)(h) Description of monument found at this corner and if it was accepted, state all evidence (material, testimonial, occupational, plats records, other monuments) used as a basis for accepting. If not accepted or nothing was found, state evidence used as basis for establishing location and what was set. If re-established through lost corner proportionate methods, indicate all monuments, distances and directions used.

1846-1847 Alfred L. Brown established original corner location 80 chains North of the Southwest corner of Section 13.

November 17, 1998 - I found a 2" Iron Pipe with a pinched top which fit occupation to the east and prorated distances across the south line of Section 11. I accepted it as the corner, replaced it with a Vernon County, and set witnesses as shown.

(c)(d)(e) Plan view of corner with ties to at lest four (4) witness monuments. If in disagreement with previously established corner, show the distances between the two corners and also indicate ties to disputed corner.

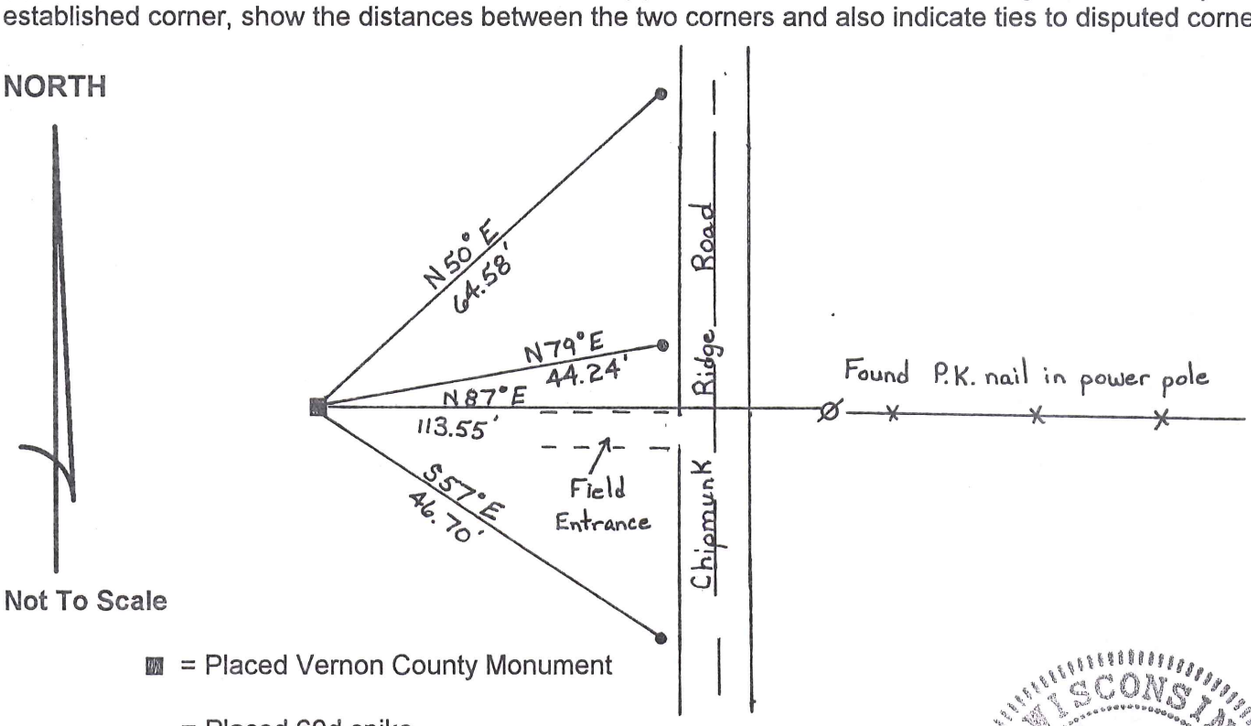

Not To Scale

■ = Placed Vernon County Monument

= Placed 60d spike

● = Placed ½" Rebar 1' West of Edge of bituminous

(I) Certify that the corner location on this record was determined by me or under my direction and control and that this U.S. Public Land survey Monument Record is correct and complete to the best of my knowledge and belief.

WISCONSIN CARL M. SANDSNES S-1819 MADISON, WISCONSIN LAND SURVEYOR

Signature Carl M. Sandsnes — December 31, 1998. Date

Filed for record in Vernon County Surveyor's Office on _____ INDEX NO. _____

(8)