FOR VERNON COUNTY, WISCONSIN

Note: This form is intended and designed to fulfill all requirements of Wisconsin Administrative Code, Chapter AE-7.08, U.S. Public Land Survey Monument Record (3)(a)(b)(c)(d)(e)(f)(g)(h)(i). Use additional sheets if necessary.

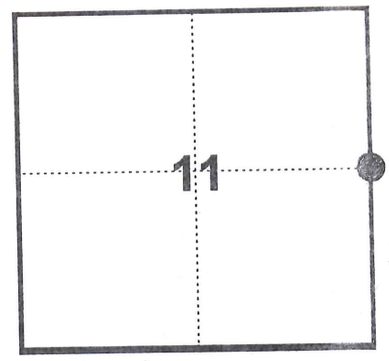

(a) Sections 11

Township(s) 14 North, Range(s) 07 West.

Vernon County Coordinates: N 202473.310

E 627664.185

(b)(f)(h) Description of monument found at this corner and if it was accepted, state all evidence (material, testimonial, occupational, plats records, other monuments) used as a basis for accepting. If not accepted or nothing was found, state evidence used as basis for establishing location and what was set. If re-established through lost corner proportionate methods, indicate all monuments, distances and directions used.

1846-1847 Alfred L. Brown established original corner location 40 chains North of the Southwest corner of Section 12.

December 29, 1998 - I found no existing evidence of the corner location occupational or otherwise. I established the corner position using occupational evidence at the Northeast corner and the 40 corner to the south. I then held the 40 corner alignment and used a doubled over distance from the 40 corner to establish the corner location. I then set witnesses as shown.

(c)(d)(e) Plan view of corner with ties to at lest four (4) witness monuments. If in disagreement with previously established corner, show the distances between the two corners and also indicate ties to disputed corner.

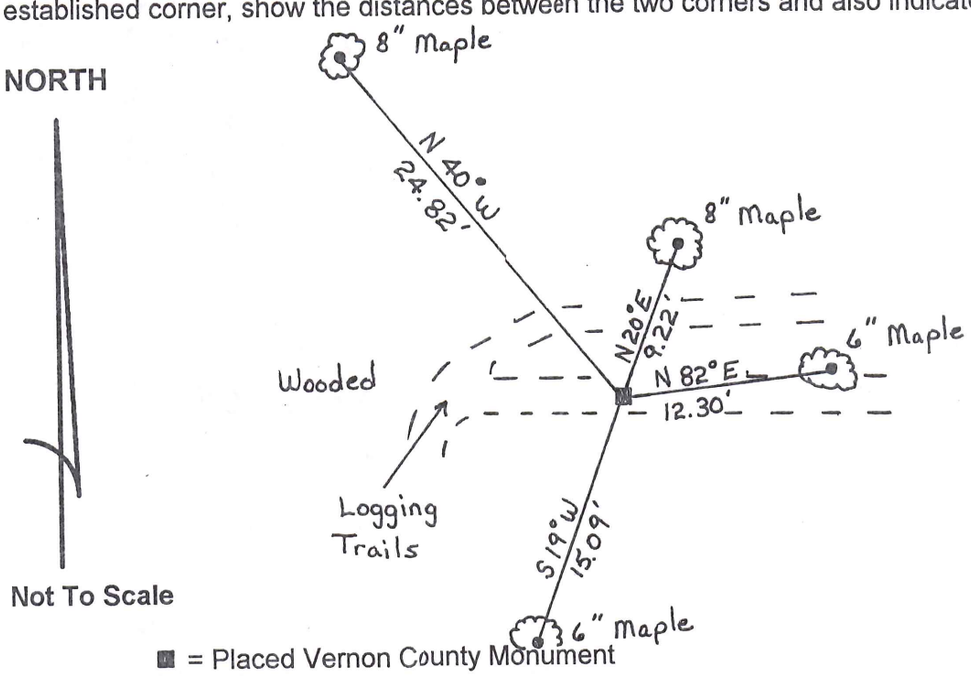

■ = Placed Vernon County Monument

● = Placed 60d spike

WISCONSIN
CARL M. SANDSNES
S-1819
MADISON, WISCONSIN
LAND SURVEYOR

(l) Certify that the corner location on this record was determined by me or under my direction and control and that this U.S. Public Land survey Monument Record is correct and complete to the best of my knowledge and belief.

Signature Carl M. Sandsnes — December 31, 1998. Date

Filed for record in Vernon County Surveyor's Office on _____ INDEX NO. _____