FOR VERNON COUNTY, WISCONSIN

Note: This form is intended and designed to fulfill all requirements of Wisconsin Administrative Code, Chapter AE-7.08, U.S. Public Land Survey Monument Record (3)(a)(b)(c)(d)(e)(f)(g)(h)(i). Use additional sheets if necessary.

(a) Sections 13

Township(s) 14 North, Range(s) 07 West.

Vernon County Coordinates: N_____

E_____

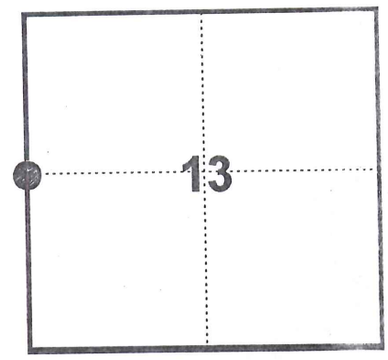

(b)(f)(h) Description of monument found at this corner and if it was accepted, state all evidence (material, testimonial, occupational, plats records, other monuments) used as a basis for accepting. If not accepted or nothing was found, state evidence used as basis for establishing location and what was set. If re-established through lost corner proportionate methods, indicate all monuments, distances and directions used.

1846-1847 Alfred L. Brown established original corner location 40 chains North of the Southwest corner of Section 13.

December 15, 1998 - I found no evidence of any kind of the original corner location. I set a Vernon County Monument on a straight line and equi-distance split between the Northwest and Southwest corners of Section 13. I then set witnesses as shown.

(c)(d)(e) Plan view of corner with ties to at lest four (4) witness monuments. If in disagreement with previously established corner, show the distances between the two corners and also indicate ties to disputed corner.

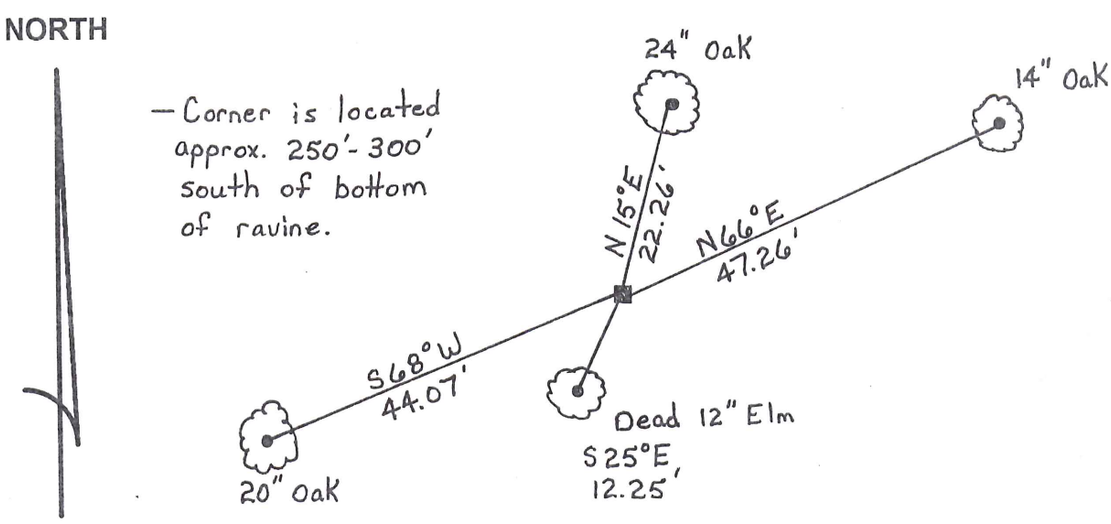

Not To Scale

■ = Placed Vernon County Monument

● = Placed 60d spike

WISCONSIN CARL M. SANDSNES S-1819 MADISON, WISCONSIN LAND SURVEYOR

(I) Certify that the corner location on this record was determined by me or under my direction and control and that this U.S. Public Land survey Monument Record is correct and complete to the best of my knowledge and belief.

Signature Carl M. Sandsnes — December 31, 1998. Date

Filed for record in Vernon County Surveyor's Office on _____ **INDEX NO.** _____