FOR VERNON COUNTY, WISCONSIN

Note: This form is intended and designed to fulfill all requirements of Wisconsin Administrative Code, Chapter AE-7.08, U.S. Public Land Survey Monument Record (3)(a)(b)(c)(d)(e)(f)(g)(h)(i). Use additional sheets if necessary.

(a) Sections 13

Township(s) 14 North, Range(s) 07 West.

Vernon County Coordinates: N 194563.468

E 627776.932

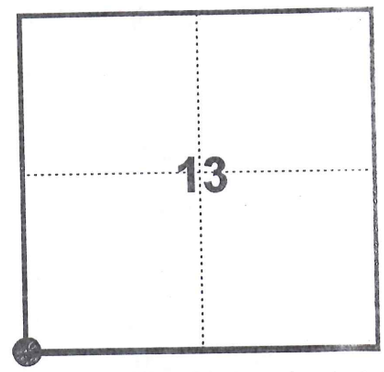

(b)(f)(h) Description of monument found at this corner and if it was accepted, state all evidence (material, testimonial, occupational, plats records, other monuments) used as a basis for accepting. If not accepted or nothing was found, state evidence used as basis for establishing location and what was set. If re-established through lost corner proportionate methods, indicate all monuments, distances and directions used.

1846-1847 Alfred L. Brown established original corner location 80 chains North of the Southeast corner of Section 23.

December 15, 1998 - I found a 60D spike at the intersection of fenclines west and south and occupation to the east. I received testimony from current land owners stating that the nail was the accepted corner marking their properties. I accepted this as the corner and replaced it with a Vernon County Monument and set witnesses as shown.

(c)(d)(e) Plan view of corner with ties to at lest four (4) witness monuments. If in disagreement with previously established corner, show the distances between the two corners and also indicate ties to disputed corner.

NORTH

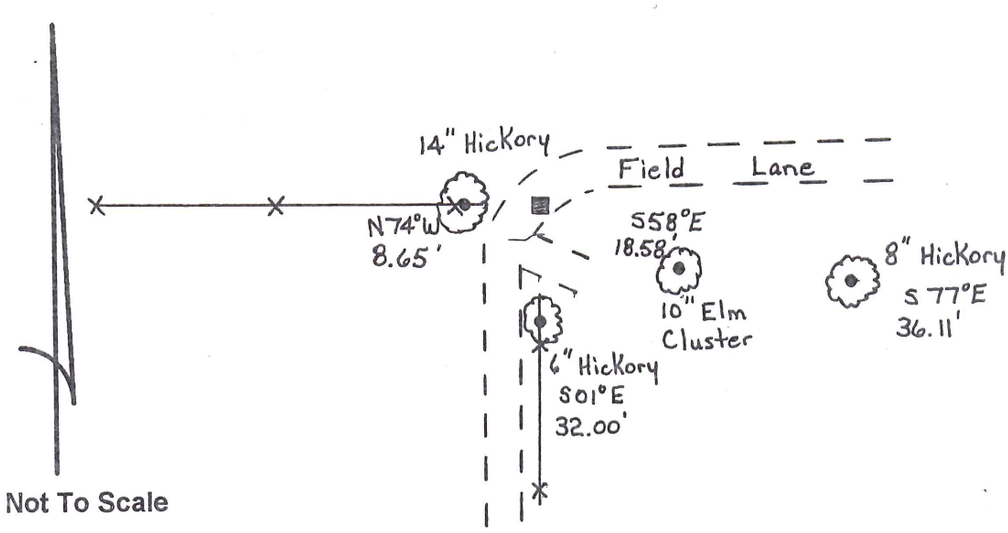

Not To Scale

▩ = Placed Vernon County Monument

● = Placed 60d spike

(l) Certify that the corner location on this record was determined by me or under my direction and control and that this U.S. Public Land survey Monument Record is correct and complete to the best of my knowledge and belief.

WISCONSIN CARL M. SANDSNES S-1618 MADISON, WISCONSIN LAND SURVEYOR

Signature Carl M. Sandsnes — Date December 31, 1998.

Filed for record in Vernon County Surveyor's Office on _____ **INDEX NO.** _____