FOR VERNON COUNTY, WISCONSIN

Note: This form is intended and designed to fulfill all requirements of Wisconsin Administrative Code, Chapter AE-7.08, U.S. Public Land Survey Monument Record (3)(a)(b)(c)(d)(e)(f)(g)(h)(i). Use additional sheets if necessary.

(a) Sections 14

Township(s) 14 North, Range(s) 07, West.

Vernon County Coordinates: N 194585.217

E 622540.145

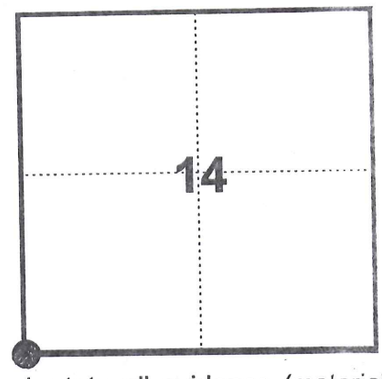

(b)(f)(h) Description of monument found at this corner and if it was accepted, state all evidence (material, testimonial, occupational, plats records, other monuments) used as a basis for accepting. If not accepted or nothing was found, state evidence used as basis for establishing location and what was set. If re-established through lost corner proportionate methods, indicate all monuments, distances and directions used.

1846-1847 Alfred L. Brown established the original corner location 80 chains east of the Southwest corner of Section 15.

December 14, 1998 - I found no evidence of the original corner location. I established the corner location using double proportionate methods from the Northwest of Section 14 to the Southwest of Section 23 and the Southwest corner of Section 15 and the South 1/4 corner of Section 14. The location is approximately 14' south of an east-west fence line. I set a Vernon County Monument and witnesses as shown.

(c)(d)(e) Plan view of corner with ties to at lest four (4) witness monuments. If in disagreement with previously established corner, show the distances between the two corners and also indicate ties to disputed corner.

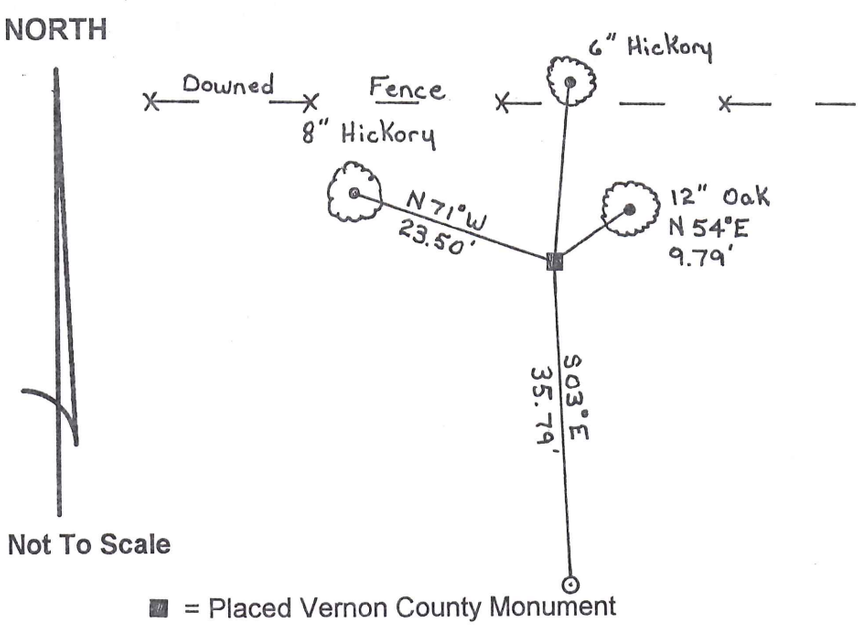

Not To Scale

■ = Placed Vernon County Monument

● = Placed 60d spike

○ = Placed 2" Iron Pipe

(l) Certify that the corner location on this record was determined by me or under my direction and control and that this U.S. Public Land survey Monument Record is correct and complete to the best of my knowledge and belief.

WISCONSIN CARL M. SANDSNES S-1819 MADISON, WISCONSIN LAND SURVEYOR

December 31, 1998.

Signature Carl M. Sandsnes — Date

Filed for record in Vernon County Surveyor's Office on _____ **INDEX NO.** _____

1001