FOR VERNON COUNTY, WISCONSIN

Note: This form is intended and designed to fulfill all requirements of Wisconsin Administrative Code, Chapter AE-7.08, U.S. Public Land Survey Monument Record (3)(a)(b)(c)(d)(e)(f)(g)(h)(i). Use additional sheets if necessary.

(a) Sections 15

Township(s) 14 North, Range(s) 07, West.

Vernon County Coordinates: N 194558.404

E 619921.582

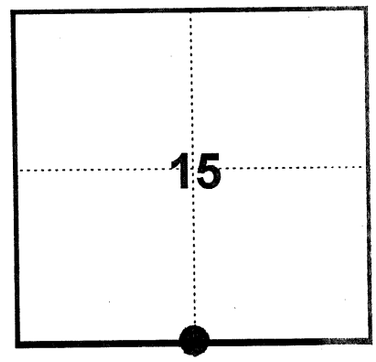

(b)(f)(h) Description of monument found at this corner and if it was accepted, state all evidence (material, testimonial, occupational, plats records, other monuments) used as a basis for accepting. If not accepted or nothing was found, state evidence used as basis for establishing location and what was set. If re-established through lost corner proportionate methods, indicate all monuments, distances and directions used.

1846-1847 Alfred L. Brown established the original corner location 40.0 chains east of the Southwest corner of Section 15.

December 16, 1998 - Found no evidence of an existing corner, reestablish the position by a straight line equal distance split between the Southwest and Southeast corners of said section 15 and set a Vernon County Monument and witnesses as shown.

(c)(d)(e) Plan view of corner with ties to at lest four (4) witness monuments. If in disagreement with previously established corner, show the distances between the two corners and also indicate ties to disputed corner.

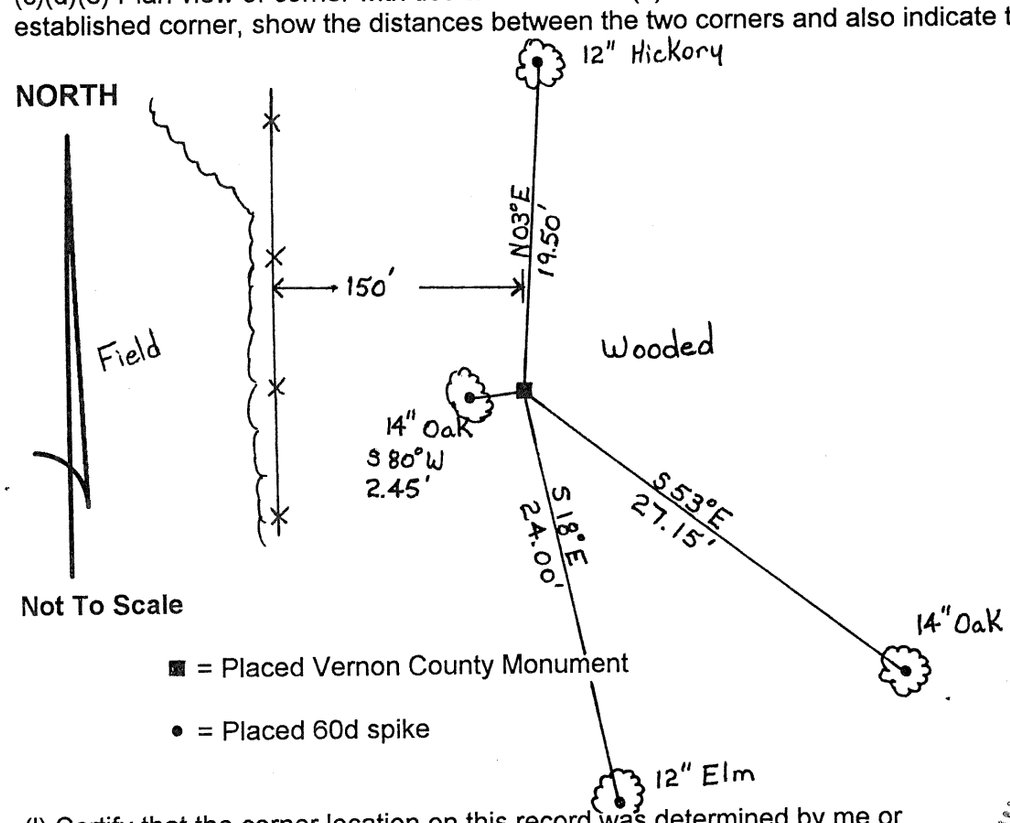

Not To Scale

■ = Placed Vernon County Monument

• = Placed 60d spike

(l) Certify that the corner location on this record was determined by me or under my direction and control and that this U.S. Public Land survey Monument Record is correct and complete to the best of my knowledge and belief.

WISCONSIN CARL M. SANDSNES S-1819 MADISON, WISCONSIN LAND SURVEYOR

Signature Carl M. Sandsnes — December 31, 1998. Date

Filed for record in Vernon County Surveyor's Office on _____ **INDEX NO.** _____

BB

(14)