FOR VERNON COUNTY, WISCONSIN

Note: This form is intended and designed to fulfill all requirements of Wisconsin Administrative Code, Chapter AE-7.08, U.S. Public Land Survey Monument Record (3)(a)(b)(c)(d)(e)(f)(g)(h)(i). Use additional sheets if necessary.

(a) Sections 15

Township(s) 14 North, Range(s) 07 West.

Vernon County Coordinates: N 197230.788

E 622484.927

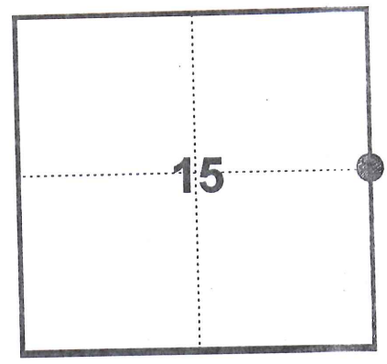

(b)(f)(h) Description of monument found at this corner and if it was accepted, state all evidence (material, testimonial, occupational, plats records, other monuments) used as a basis for accepting. If not accepted or nothing was found, state evidence used as basis for establishing location and what was set. If re-established through lost corner proportionate methods, indicate all monuments, distances and directions used.

1846-1847 Alfred L. Brown established original corner location 40 chains North of the Southwest corner of Section 14.

December 23, 1998- Established corner location by straight line equi-distance split between the Northwest corner of Section 14 and the Southwest corner of Section 14. No monument was set due to the fact that the location fell in a cultivated field. Witness monuments to the corner position were set as shown.

(c)(d)(e) Plan view of corner with ties to at lest four (4) witness monuments. If in disagreement with previously established corner, show the distances between the two corners and also indicate ties to disputed corner.

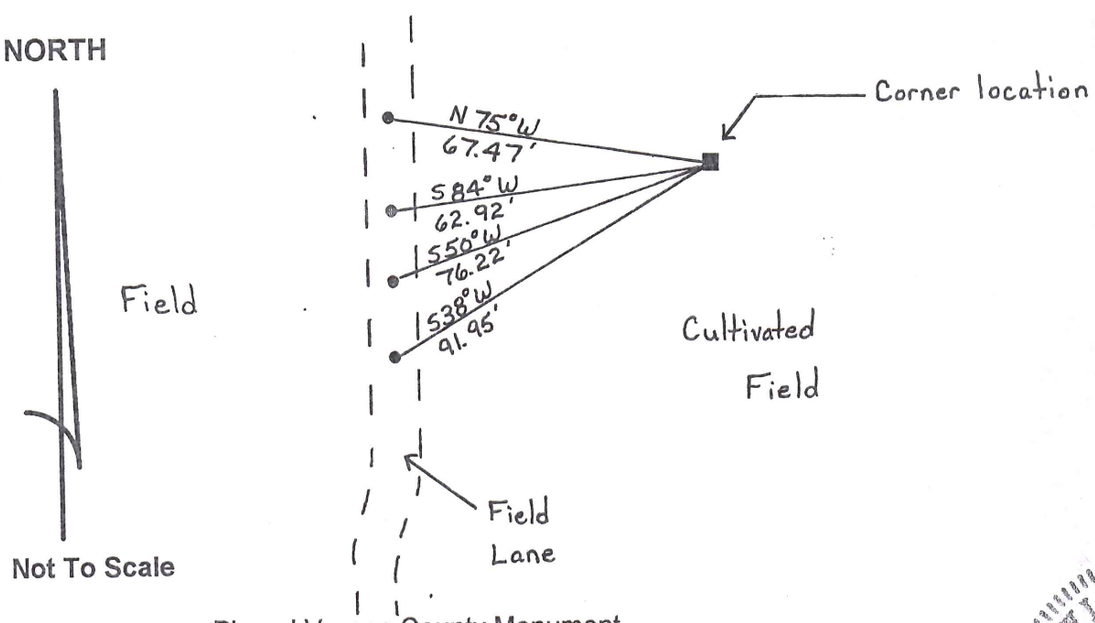

= Placed Vernon County Monument

= Placed 60d spike

• = Placed 3/8" Rebar in ℄ of field lane.

(I) Certify that the corner location on this record was determined by me or under my direction and control and that this U.S. Public Land survey Monument Record is correct and complete to the best of my knowledge and belief.

WISCONSIN CARL M. SANDSNES S-1619 MADISON, WISCONSIN LAND SURVEYOR

Signature Carl M. Sandsnes — December 31, 1998. Date

Filed for record in Vernon County Surveyor's Office on

INDEX NO.